

Work Order ID 94514

94514

Page 1

December-19-12 11:34:36 AM

Item ID: D3290-041

Accept

N900040100

Setup Start ***NS1***

Revision ID:

Stop ***NS2***

Item Name: Replacement Window Assembly

Start Date: 1/15/13 Start Qty: 4.00

Cust Item ID:

Required Date: 1/15/13 Req'd Qty: 4.00

Customer:

Reference:

Approvals: Process Plan: MLJ Date: 12-12-20 Tooling: _____ Date: _____

Run Start ***NR1***

QC: _____ Date: _____ SPC (Y/N): _____ Date: _____

Stop ***NR2***

Sequence ID/ Work Center ID	Operation Description	Set Up/ Run Hours	Tool ID	Tool #	Plan Code	Accept Qty	Reject Qty	Reject Number	Insp. Stamp
Draw Nbr	Revision Nbr								
D3290.	Rev C								
150	Pick Kit	0.00							
150									
Packaging	Memo	0.00							
Packaging									
160		0.00							
160	Small Fab								
Small Fab	Memo	0.00							
Small Fab	Assemble as per Dwg D3290 Clean D3290-041 and place in plastic wrap								
170	QC5- Inspect part completeness to step on W/O	0.00							
170									
QC	Memo	0.00							
Quality Control									

(9) SAD 13-04-22

(9) SAD 13-04-22

9

AS 27 13 4 22

NCR: Yes / No

WORK ORDER NON-CONFORMANCE / UPDATE

DQA: _____ Date: _____

QA Closed: _____ Date: _____

Work Order: _____ Part No. _____ NCR No. _____				DISPOSITION Rework <input type="checkbox"/> Scrap <input type="checkbox"/> Use-as-is <input type="checkbox"/> Work Order Update <input type="checkbox"/>		AGAINST DEPARTMENT/PROCESS <div style="display: flex; justify-content: space-between;"> <div> Skid-tube <input type="checkbox"/> Machining <input type="checkbox"/> Thermoforming <input type="checkbox"/> Large Fab <input type="checkbox"/> </div> <div> Crosstube <input type="checkbox"/> Small Fab <input type="checkbox"/> Finishing <input type="checkbox"/> Composite <input type="checkbox"/> </div> <div> Water Jet <input type="checkbox"/> Prod. Eng. Coord. <input type="checkbox"/> Rec/Store/Packaging <input type="checkbox"/> Supplier <input type="checkbox"/> </div> <div> Engineering <input type="checkbox"/> Quality <input type="checkbox"/> Other <input type="checkbox"/> </div> </div>					
Root Cause	Date	Step	Qty	Description of work order update or Non-conformance	Initial Chief Eng	Action Description	Sign & Date	Verification	QC Inspector		
Doc/Data <input type="checkbox"/>											
Equip/Tooling <input type="checkbox"/>											
Operator <input type="checkbox"/>											
Material <input type="checkbox"/>											
Setup <input type="checkbox"/>											
Other <input type="checkbox"/>											
Process <input type="checkbox"/>											
Supplier <input type="checkbox"/>											
Training <input type="checkbox"/>											
Unapproved <input type="checkbox"/>											

FAULT CATEGORY			
Landing Gear <input type="checkbox"/> Bending <input type="checkbox"/> Centre Not Concentric to O/S <input type="checkbox"/> Cracks <input type="checkbox"/> Crushed/Crimped <input type="checkbox"/> Cuffs <input type="checkbox"/> Heat Treat <input type="checkbox"/> Inspection Strip in Tube <input type="checkbox"/> Ripples in Bend <input type="checkbox"/> Torque Waves in Extrusion <input type="checkbox"/> Turning Sequence <input type="checkbox"/> Wave/Twist in Tube	General <input type="checkbox"/> Bend <input type="checkbox"/> BOM/Route <input type="checkbox"/> Broken/Damaged <input type="checkbox"/> Burrs <input type="checkbox"/> Contamination <input type="checkbox"/> Countersink <input type="checkbox"/> Cut Too Short <input type="checkbox"/> Drill Holes <input type="checkbox"/> Drawing <input type="checkbox"/> Finish <input type="checkbox"/> Folio	<input type="checkbox"/> Grain <input type="checkbox"/> Hardware <input type="checkbox"/> Inspection Incomplete <input type="checkbox"/> Instructions Incomplete/Unclear <input type="checkbox"/> Maintenance <input type="checkbox"/> Mislabeled <input type="checkbox"/> Misread <input type="checkbox"/> Offset <input type="checkbox"/> Out of Calibration <input type="checkbox"/> Out of Sequence <input type="checkbox"/> Outside Dimensions	<input type="checkbox"/> Ovalized <input type="checkbox"/> Over/Under tolerance <input type="checkbox"/> Part Incorrect <input type="checkbox"/> Part Lost/Missing <input type="checkbox"/> Part Moved <input type="checkbox"/> Positioned Wrong <input type="checkbox"/> Power Loss/Surge <input type="checkbox"/> Pressure/Forced <input type="checkbox"/> Temperature/Cure <input type="checkbox"/> Weld <input type="checkbox"/> Wrong Stock Pulled <input type="checkbox"/> Other

Work Order ID 94514

94514

Page 2

December-19-12 11:34:36 AM

Item ID: D3290-041 Accept ***N900040100*** Setup Start ***NS1***
 Revision ID: Stop ***NS2***
 Item Name: Replacement Window Assembly
 Start Date: 1/15/13 Start Qty: 4.00 ***4*** Cust Item ID:
 Required Date: 1/15/13 Req'd Qty: 4.00 ***4*** Customer:
 Reference:

Approvals: Process Plan: _____ Date: _____ Tooling: _____ Date: _____ Run Start ***NR1***
 QC: _____ Date: _____ SPC (Y/N): _____ Date: _____ Stop ***NR2***

Sequence ID/ Work Center ID	Operation Description	Set Up/ Run Hours	Tool ID	Tool #	Plan Code	Accept Qty	Reject Qty	Reject Number	Insp. Stamp
180	Identify as per dwg & Stock Location. ST2/3	0.00				9X			SD
180									
Packaging	Memo	0.00							
Packaging									13-4-23
190	QC21- Final Inspection - Work Order Release	0.00							
190									
QC	Memo	0.00							13/4/24
Quality Control									

13-04-24

NCR: Yes / No

WORK ORDER NON-CONFORMANCE / UPDATE

DQA: _____ Date: _____

QA Closed: _____ Date: _____

Work Order: _____ Part No. _____ NCR No. _____	DISPOSITION Rework <input type="checkbox"/> Scrap <input type="checkbox"/> Use-as-is <input type="checkbox"/> Work Order Update <input type="checkbox"/>	AGAINST DEPARTMENT/PROCESS <table style="width: 100%;"> <tr> <td>Skid-tube <input type="checkbox"/></td> <td>Crosstube <input type="checkbox"/></td> <td>Water Jet <input type="checkbox"/></td> <td>Engineering <input type="checkbox"/></td> </tr> <tr> <td>Machining <input type="checkbox"/></td> <td>Small Fab <input type="checkbox"/></td> <td>Prod. Eng. Coord. <input type="checkbox"/></td> <td>Quality <input type="checkbox"/></td> </tr> <tr> <td>Thermoforming <input type="checkbox"/></td> <td>Finishing <input type="checkbox"/></td> <td>Rec/Store/Packaging <input type="checkbox"/></td> <td>Other <input type="checkbox"/></td> </tr> <tr> <td>Large Fab <input type="checkbox"/></td> <td>Composite <input type="checkbox"/></td> <td>Supplier <input type="checkbox"/></td> <td></td> </tr> </table>	Skid-tube <input type="checkbox"/>	Crosstube <input type="checkbox"/>	Water Jet <input type="checkbox"/>	Engineering <input type="checkbox"/>	Machining <input type="checkbox"/>	Small Fab <input type="checkbox"/>	Prod. Eng. Coord. <input type="checkbox"/>	Quality <input type="checkbox"/>	Thermoforming <input type="checkbox"/>	Finishing <input type="checkbox"/>	Rec/Store/Packaging <input type="checkbox"/>	Other <input type="checkbox"/>	Large Fab <input type="checkbox"/>	Composite <input type="checkbox"/>	Supplier <input type="checkbox"/>	
Skid-tube <input type="checkbox"/>	Crosstube <input type="checkbox"/>	Water Jet <input type="checkbox"/>	Engineering <input type="checkbox"/>															
Machining <input type="checkbox"/>	Small Fab <input type="checkbox"/>	Prod. Eng. Coord. <input type="checkbox"/>	Quality <input type="checkbox"/>															
Thermoforming <input type="checkbox"/>	Finishing <input type="checkbox"/>	Rec/Store/Packaging <input type="checkbox"/>	Other <input type="checkbox"/>															
Large Fab <input type="checkbox"/>	Composite <input type="checkbox"/>	Supplier <input type="checkbox"/>																

Root Cause	Date	Step	Qty	Description of work order update or Non-conformance	Initial Chief Eng	Action Description	Sign & Date	Verification	QC Inspector
Doc/Data									
Equip/Tooling									
Operator									
Material									
Setup									
Other									
Process									
Supplier									
Training									
Unapproved									

FAULT CATEGORY

Landing Gear	General	Other
<input type="checkbox"/> Bending	<input type="checkbox"/> Bend	<input type="checkbox"/> Grain
<input type="checkbox"/> Centre Not Concentric to O/S	<input type="checkbox"/> BOM/Route	<input type="checkbox"/> Hardware
<input type="checkbox"/> Cracks	<input type="checkbox"/> Broken/Damaged	<input type="checkbox"/> Inspection Incomplete
<input type="checkbox"/> Crushed/Crimped	<input type="checkbox"/> Burrs	<input type="checkbox"/> Instructions Incomplete/Unclear
<input type="checkbox"/> Cuffs	<input type="checkbox"/> Contamination	<input type="checkbox"/> Maintenance
<input type="checkbox"/> Heat Treat	<input type="checkbox"/> Countersink	<input type="checkbox"/> Mislabeled
<input type="checkbox"/> Inspection Strip in Tube	<input type="checkbox"/> Cut Too Short	<input type="checkbox"/> Misread
<input type="checkbox"/> Ripples in Bend	<input type="checkbox"/> Drill Holes	<input type="checkbox"/> Offset
<input type="checkbox"/> Torque Waves in Extrusion	<input type="checkbox"/> Drawing	<input type="checkbox"/> Out of Calibration
<input type="checkbox"/> Turning Sequence	<input type="checkbox"/> Finish	<input type="checkbox"/> Out of Sequence
<input type="checkbox"/> Wave/Twist in Tube	<input type="checkbox"/> Folio	<input type="checkbox"/> Outside Dimensions
		<input type="checkbox"/> Ovalized
		<input type="checkbox"/> Over/Under tolerance
		<input type="checkbox"/> Part Incorrect
		<input type="checkbox"/> Part Lost/Missing
		<input type="checkbox"/> Part Moved
		<input type="checkbox"/> Positioned Wrong
		<input type="checkbox"/> Power Loss/Surge
		<input type="checkbox"/> Pressure/Forced
		<input type="checkbox"/> Temperature/Cure
		<input type="checkbox"/> Weld
		<input type="checkbox"/> Wrong Stock Pulled
		<input type="checkbox"/> Other

Picklist Print

December-19-12 11:34:35 AM

Page 1

Work Order ID: 94514

Parent Item: D3290-041

Parent Item Name: Replacement Window Assembly

Start Date: 1/15/13

Required Date: 1/15/13

Start Qty: 4.00

Required Qty: 4.00

Comments: IPP B05.05.25Added Step 11KJ/JLM
IPP C06.05.09Ecn 798 EC
IPP Rev:D Now on Waterjet 06-06-16 JLM
IPP rev E rev C dwg 07.09.28 EC verified by: DD

Component Item ID/ Item Name	Replacement Item ID	Mfg/ Purch	Bin Item	Primary Location	Last Location	Route Seq ID	Unit of Measure	Qty on Hand	Qty per Kit	Total Qty	Qty Issued	Date Issued	Status
D3290-1 Window Frame		Manufactured	No			150	Each	7.0000	1	4		SAD 13-04-22	
				<u>Location</u>		<u>Loc Qty</u>		<u>Loc Code</u>					
				ST213		7							
				73721		2		B97046	4				
				89917		1		B94420	4				
				92812		4							
D2126 Seal		Manufactured	No			150	f	485.2603	6.5	26		SAD 13-04-22	
				<u>Location</u>		<u>Loc Qty</u>		<u>Loc Code</u>					
				ST405		485.26029							
				57106		4							
				68336		2.44679							
				76094		4.8135							
				89058		474			58.6				
D3290-3 Window		Manufactured	No			150	Each	9.0000	1	4		SAD 13-04-22	
				<u>Location</u>		<u>Loc Qty</u>		<u>Loc Code</u>					
				ST214A		9							
				93792		9		B94678	4				
								97332	5				

NCR: Yes / No



WORK ORDER NON-CONFORMANCE / UPDATE

DQA: _____ Date: _____

QA Closed: _____ Date: _____

Work Order: _____ Part No. _____ NCR No. _____				DISPOSITION Rework <input type="checkbox"/> Scrap <input type="checkbox"/> Use-as-is <input type="checkbox"/> Work Order Update <input type="checkbox"/>		AGAINST DEPARTMENT/PROCESS <div style="display: flex; justify-content: space-between;"> <div> Skid-tube <input type="checkbox"/> Machining <input type="checkbox"/> Thermoforming <input type="checkbox"/> Large Fab <input type="checkbox"/> </div> <div> Crosstube <input type="checkbox"/> Small Fab <input type="checkbox"/> Finishing <input type="checkbox"/> Composite <input type="checkbox"/> </div> <div> Water Jet <input type="checkbox"/> Prod. Eng. Coord. <input type="checkbox"/> Rec/Store/Packaging <input type="checkbox"/> Supplier <input type="checkbox"/> </div> <div> Engineering <input type="checkbox"/> Quality <input type="checkbox"/> Other <input type="checkbox"/> </div> </div>					
Root Cause	Date	Step	Qty	Description of work order update or Non-conformance	Initial Chief Eng	Action Description	Sign & Date	Verification	QC Inspector		
Doc/Data											
Equip/Tooling											
Operator											
Material											
Setup											
Other											
Process											
Supplier											
Training											
Unapproved											

FAULT CATEGORY			
Landing Gear <input type="checkbox"/> Bending <input type="checkbox"/> Centre Not Concentric to O/S <input type="checkbox"/> Cracks <input type="checkbox"/> Crushed/Crimped <input type="checkbox"/> Cuffs <input type="checkbox"/> Heat Treat <input type="checkbox"/> Inspection Strip in Tube <input type="checkbox"/> Ripples in Bend <input type="checkbox"/> Torque Waves in Extrusion <input type="checkbox"/> Turning Sequence <input type="checkbox"/> Wave/Twist in Tube	General <input type="checkbox"/> Bend <input type="checkbox"/> BOM/Route <input type="checkbox"/> Broken/Damaged <input type="checkbox"/> Burrs <input type="checkbox"/> Contamination <input type="checkbox"/> Countersink <input type="checkbox"/> Cut Too Short <input type="checkbox"/> Drill Holes <input type="checkbox"/> Drawing <input type="checkbox"/> Finish <input type="checkbox"/> Folio	<input type="checkbox"/> Grain <input type="checkbox"/> Hardware <input type="checkbox"/> Inspection Incomplete <input type="checkbox"/> Instructions Incomplete/Unclear <input type="checkbox"/> Maintenance <input type="checkbox"/> Mislabeled <input type="checkbox"/> Misread <input type="checkbox"/> Offset <input type="checkbox"/> Out of Calibration <input type="checkbox"/> Out of Sequence <input type="checkbox"/> Outside Dimensions	<input type="checkbox"/> Ovalized <input type="checkbox"/> Over/Under tolerance <input type="checkbox"/> Part Incorrect <input type="checkbox"/> Part Lost/Missing <input type="checkbox"/> Part Moved <input type="checkbox"/> Positioned Wrong <input type="checkbox"/> Power Loss/Surge <input type="checkbox"/> Pressure/Forced <input type="checkbox"/> Temperature/Cure <input type="checkbox"/> Weld <input type="checkbox"/> Wrong Stock Pulled <input type="checkbox"/> Other

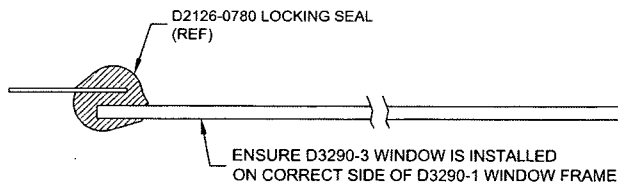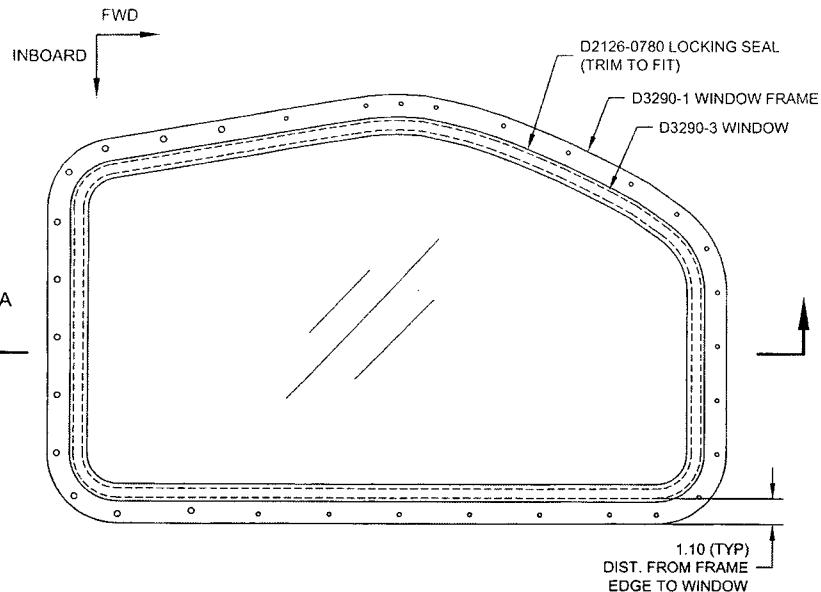


SECTION A-A NTS

D3290-041 REPLACEMENT WINDOW ASSEMBLY

D3290-041 NOTES:
1) WEIGHT: 3.66 LBS

GENERAL NOTES:

- 1) TOLERANCES: PER DART QSI 018 UNLESS OTHERWISE NOTED
- 2) UNITS: INCHES UNLESS OTHERWISE NOTED

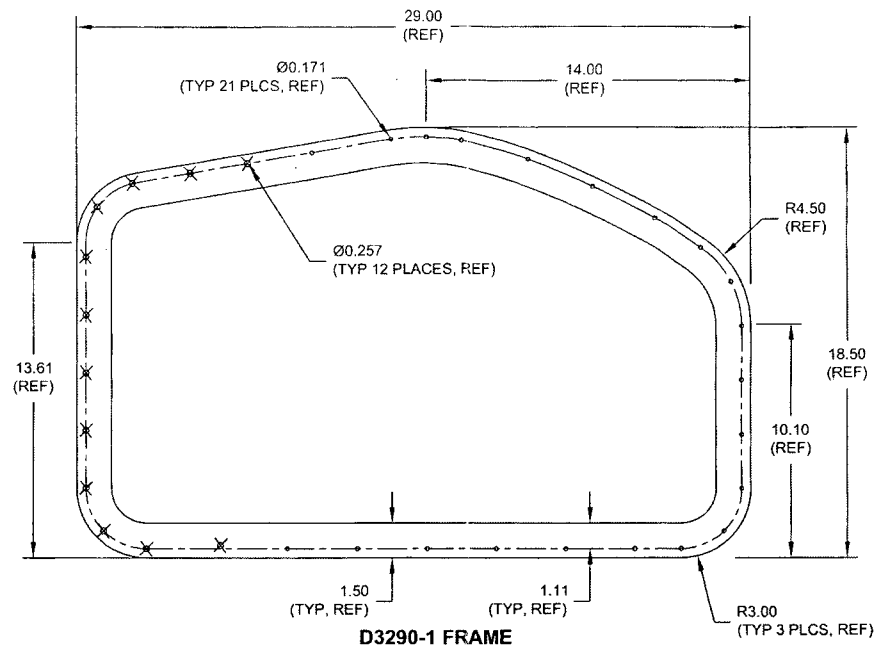

D3290-1 FRAME

D3290-1 NOTES:

- 1) MATERIAL: 6061-T6 (OR 6061-T62) ALUMINUM SHEET 0.040 THICK
PER AMS-QQ-A-250/11 OR AMS 4025 OR AMS 4027
(REF. DART SPEC. M6061T6S.040)
OR
5052-H32 ALUMINUM SHEET 0.040 THICK
PER AMS-QQ-A-250/8 OR AMS 4016
(REF. DART SPEC. M5052H32S.040)
- 2) FINISH: CHEMICAL CONVERSION COAT PER QSI 005 4.1
POWDER COAT WHITE (REF. 4.5.3.1) PER DART QSI 005 4.3
- 3) BREAK SHARP EDGES: 0.005 TO 0.010 MAX
- 4) IDENTIFICATION: IDENTIFY WITH DART P/N "D3290-1" USING FINE POINT PERMANENT INK MARKER
- 5) WEIGHT: 0.47 LBS

RELEASED
07.07.24

DEO ATTACHED

UNDER REVIEW

6/07/01-18
7/12/07-037
6/9/12/19

C	UPDATE DIMS PER PAR 188	DC	07.07.24
B	UPDATE MATERIAL PER NCR 029	MB	06.04.20
A	NEW ISSUE	RF	04.06.14
REV.	DESCRIPTION	BY	DATE
DESIGN	<i>[Signature]</i>		
DRAWN	<i>[Signature]</i>		
CHECKED	<i>[Signature]</i>		
MFG. APPR.	<i>[Signature]</i>		
APPROVED	<i>[Signature]</i>		
DE APPR.	<i>[Signature]</i>		
DATE	07.07.24		

DART AEROSPACE LTD
HAWKESBURY, ONTARIO, CANADA

DRAWING NO. REV. C
D3290 SHEET 1 OF 2


TITLE SCALE
REPLACEMENT WINDOW ASSEMBLY 1:5

COPYRIGHT © 2004 BY DART AEROSPACE LTD
THIS DOCUMENT IS PRIVATE AND CONFIDENTIAL AND IS SUPPLIED ON THE EXPRESS CONDITION THAT IT IS NOT TO BE USED FOR ANY PURPOSE OR CORRECT OR COMPARABLE TO ANY OTHER PERSON WITHOUT WRITTEN PERMISSION FROM DART AEROSPACE LTD

SHOP COPY
RETURN TO
ENGINEERING
UNCONTROLLED COPY
SUBJECT TO AMENDMENT
WITHOUT NOTICE
WORK ORDER

NO. 94514 MJS
12-12-20

94514

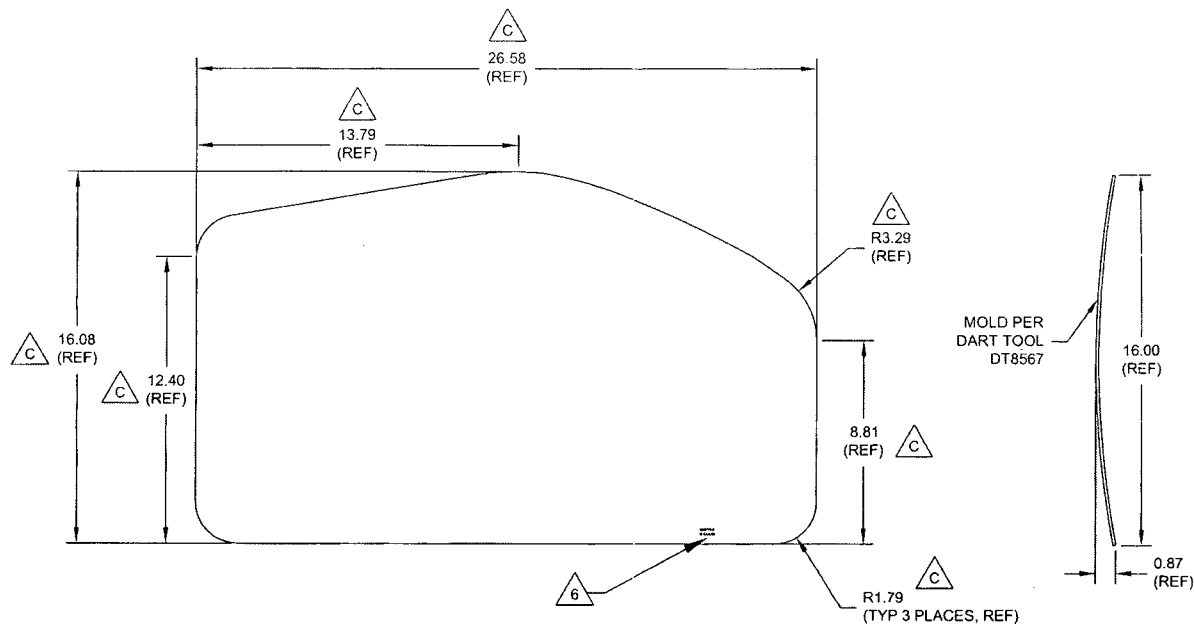

D3290-3 WINDOW

- D3290-3 NOTES:**
- 1) MATERIAL: POLYCAST II CLEAR ACRYLIC SHEET PER MIL-P-5425 OR PLEXIGLAS G CLEAR CAST ACRYLIC SHEET PER LP-391 TYPE 1 GRADE C, 0.125 THICK (REF. DART SPEC. M-ACRYLIC-S.125)
 - 2) FINISH: NONE
 - 3) TOLERANCES: PER DART QSI 018 UNLESS OTHERWISE NOTED
 - 4) UNITS: INCHES UNLESS OTHERWISE NOTED
 - 5) REMOVE SHARP EDGES
 - 6) IDENTIFICATION: ENGRAVE P/N "D3290-3" AND B/N ON LOWER EDGE USE 0.125" HIGH LETTERS TO MAXIMUM DEPTH OF 0.005"
 - 7) WEIGHT: 1.87 +/- 0.42 LBS
 - 8) MOLD PER DART TOOL DT8567

UNDER REVIEW

**DEO ATTACHED
RELEASED**
07.09.22

DESIGN	3#	DART AEROSPACE LTD	
DRAWN	DE	HAWKESBURY, ONTARIO, CANADA	
CHECKED	DE	DRAWING NO.	REV. C
MFG. APPR.	RP	D3290	SHEET 2 OF 2
APPROVED	DE	TITLE	SCALE
DE APPR.	DE	REPLACEMENT WINDOW ASSEMBLY 1:5	
DATE	07.07.24	COPYRIGHT © 2004 BY DART AEROSPACE LTD	
THIS DOCUMENT IS UNCLASSIFIED AND CONFIDENTIAL AND IS SUPPLIED ON THE EXPRESS CONDITION THAT IT IS NOT TO BE USED FOR ANY PURPOSE, OR COPIED OR COMMUNICATED TO ANY OTHER PERSON WITHOUT WRITTEN PERMISSION FROM DART AEROSPACE LTD.			

94514

DRAWING NO. D3290	TITLE REPLACEMENT WINDOW ASSEMBLY	REV. C	DART AEROSPACE LTD ENGINEERING ORDER		D.E.O. NO. D3290-C-1	SHEET NO. SHEET 1 OF 1	SCALE NTS
DRAWN <i>q</i>	CHECKED <i>1</i>	MFG. APPR. <i>E</i>	APPROVED <i>NP</i>		DE APPR. <i>#</i>		
DATE 09.09.18	DATE 09.09.18	DATE 09.09.18	DATE 09/09/21		DATE 09/09/21		

PURPOSE:

CHANGE MATERIAL THICKNESS OF D3290-1 FRAME TO 0.063 FROM 0.040. REF PAR 09-033.

CHANGE:

MATERIAL CALL-OUT OF D3290-1 FRAME ON SHEET 1 IS AMENDED AS FOLLOWS:

D3290-1 NOTES

- 1) MATERIAL: 6061-T6 (OR 6061-T62) ALUMINUM SHEET ~~0.040 THICK~~ 0.063 THICK (REPLACE)
 PER AMS-QQ-A-250/11 OR AMS 4025 OR AMS 4027
~~(REF. DART SPEC. M6061T6S.040)~~ REF. DART SPEC. M6061T6S.063 (REPLACE)
 OR
 5052-H32 ALUMINUM SHEET ~~0.040 THICK~~ 0.063 THICK (REPLACE)
 PER AMS-QQ-A-250/8 OR AMS 4016
~~(REF. DART SPEC. M5052H32S.040)~~ REF. DART SPEC. M5052H32S.063 (REPLACE)

RELEASED
 2009-10-09
WTP